

Customer	: CU-DAR001 Dart Helicopters Services	Drawing Name	: STEP LEG
Job Number	: 27590C		
Estimate Number	: 10382		
P.O. Number	: <i>N/A</i>	Part Number	: D30655
This Issue	: 6/15/2006 S.O. No. : <i>N/A</i>	Drawing Number	: D3065 REV. A2
Prsht Rev.	: NC	Project Number	: N/A
First Issue	: 6/15/2006 Type : SMALL /MED FAB	Drawing Revision	: A2
Previous Run	: 26928C	Material	: <i>N/A</i>
Written By	: <u><i>[Signature]</i></u>	Due Date	: 7/2/2006
Checked & Approved By	: <u><i>[Signature]</i></u>	Qty:	120 Um: Each
Comment	: Est:C 02.14.01 Incorporated D3066-1 IPP KJ/RF		
	: Est Rev:D Now on Water Jet 06-04-11 JLM		
	: Est Rev:E Now manufactured with 6061-T6 06-05-25 JLM		

Job Number:



Seq. #:	Machine Or Operation:	Description :
1	1000	1000
2	1000	1000
1.0 M6061T6S080 6061-T6 .080 Sheet



Comment: Qty.: 1.1338 sf(s)/Unit Total : 136.0548 sf(s)

Material: 6061-T6 0.080" thick
(M6061T6S.080)

Batch:

FLOW WATER JET

2.0 WATER JET



Comment: FLOW WATER JET

1-Cut as per Dwg D

Dwg Rev: A2

Prog Rev: AZ

2-Deburr if necessary

3.0

QC2

INSPECT PARTS AS THEY COME OFF MACHINE



Comment: INSPECT PARTS AS THEY COME OFF MACHINE

4.0

QC8

SECOND CHECK



Comment: SECOND CHECK

5.0

SMALL FAB 1

SMALL & MEDIUM FAB RESOURCE 1



Comment: SMALL & MEDIUM FAB RESOURCE 1

Deburr Stack

W/O:		WORK ORDER CHANGES					
DATE	STEP	PROCEDURE CHANGE	By	Date	Qty	Approval Mfg / Design Mgr	Approval QC Inspector

NCR: 27590C		WORK ORDER NON-CONFORMANCE (NCR)						
DATE	STEP	Description of NC Section A	Corrective Action Section B			Verification Section C	Approval Design Mgr	Approval QC Inspector
			Initial Design Mgr	Action Description Design Mgr	Sign & Date			
06-08-16	2	111 parts Scrap, because the holes were not in tolerance 80.128" & were .140	<i>[Signature]</i>	Scrap & destroy & replace	SAD 06-09-14	<i>[Signature]</i> 06-09-05	<i>[Signature]</i> 06-08-16	<i>[Signature]</i> 06-08-16

Part No: D3065-5 PAR #: N/A Fault Category: Prod / FAB' ISS ^{meo & small} NCR: Yes No DQA: [Signature] Date: 06/10/02

NOTE: Date & initial all entries QA: N/C Closed: [Signature] Date: 06.10.03

Date: Thursday, 6/15/2006 1:56:12 PM
User: Kim Johnston

Process Sheet

Customer: CU-DAR001 Dart Helicopters Services

Drawing Name: STEP LEG

Job Number: 27590C

Part Number: D30655

Job Number:



Seq. #:

Machine Or Operation:

Description :

6.0

QC5

INSPECT WORK TO CURRENT STEP



Comment: INSPECT WORK TO CURRENT STEP

SB 06/09/22 (27)

7.0

HAND FINISHING1

HAND FINISHING RESOURCE #1



Comment: HAND FINISHING RESOURCE #1

Chemical Conversion Coat as per QSI 005 4.1

SAN 06/09/24 126

8.0

QC3

INSPECT POWDER COAT/CHEMICAL CONVERSION



Comment: INSPECT CHEMICAL CONVERSION COAT

SB 06/09/28

9.0

PACKAGING 1

PACKAGING RESOURCE #1



Comment: PACKAGING RESOURCE #1

Identify and Stock

Location: _____

GA

TOOR

50

11/19/29 (75)

10.0

DC

DOCUMENT CONTROL



Comment: DOCUMENT CONTROL

Inspection Level 21


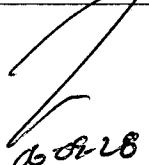
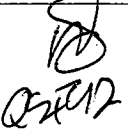

PD 06/09/29

Job Completion



W D 06/09/29

W/O:		WORK ORDER CHANGES					
DATE	STEP	PROCEDURE CHANGE	By	Date	Qty	Approval Mfg / Design Mgr	Approval QC Inspector

NCR:		WORK ORDER NON-CONFORMANCE (NCR)						
DATE	STEP	Description of NC Section A	Corrective Action Section B			Verification Section C	Approval Design Mgr	Approval QC Inspector
			Initial Design Mgr	Action Description Design Mgr	Sign & Date			
06.09.28	7	Lost one piece in Alodine, can't find.		Qty 126.	SAD 06.09.28	 06.09.28	 06.09.28	 06.09.28

Part No: _____ PAR #: _____ Fault Category: _____ NCR: Yes No DQA: _____ Date: _____

NOTE: Date & initial all entries

QA: N/C Closed: _____ Date: _____

DART


DESIGN	<i>CP</i>	DRAWN BY	<i>CP</i>	DART AEROSPACE LTD HAWKESBURY, ONTARIO, CANADA	
CHECKED	<i>#</i>	APPROVED	<i>#</i>	DRAWING NO. D3065	REV. A SHEET 1 OF 5
DATE	02.09.11			TITLE STEP LEG ASSEMBLY	SCALE 1:2
A	02.09.11			NEW ISSUE	
A1	03.02.13 <i>CP</i>			ADD SLOTS TO D3065-5	
A2	03.02.27 <i>CP</i>			0.531 WAS 0.410	

~~RELEASED~~
02.04.20 *#*

UNDER REVIEW

~~02.06 02.06~~
material change

OK *CP* 06.06.13

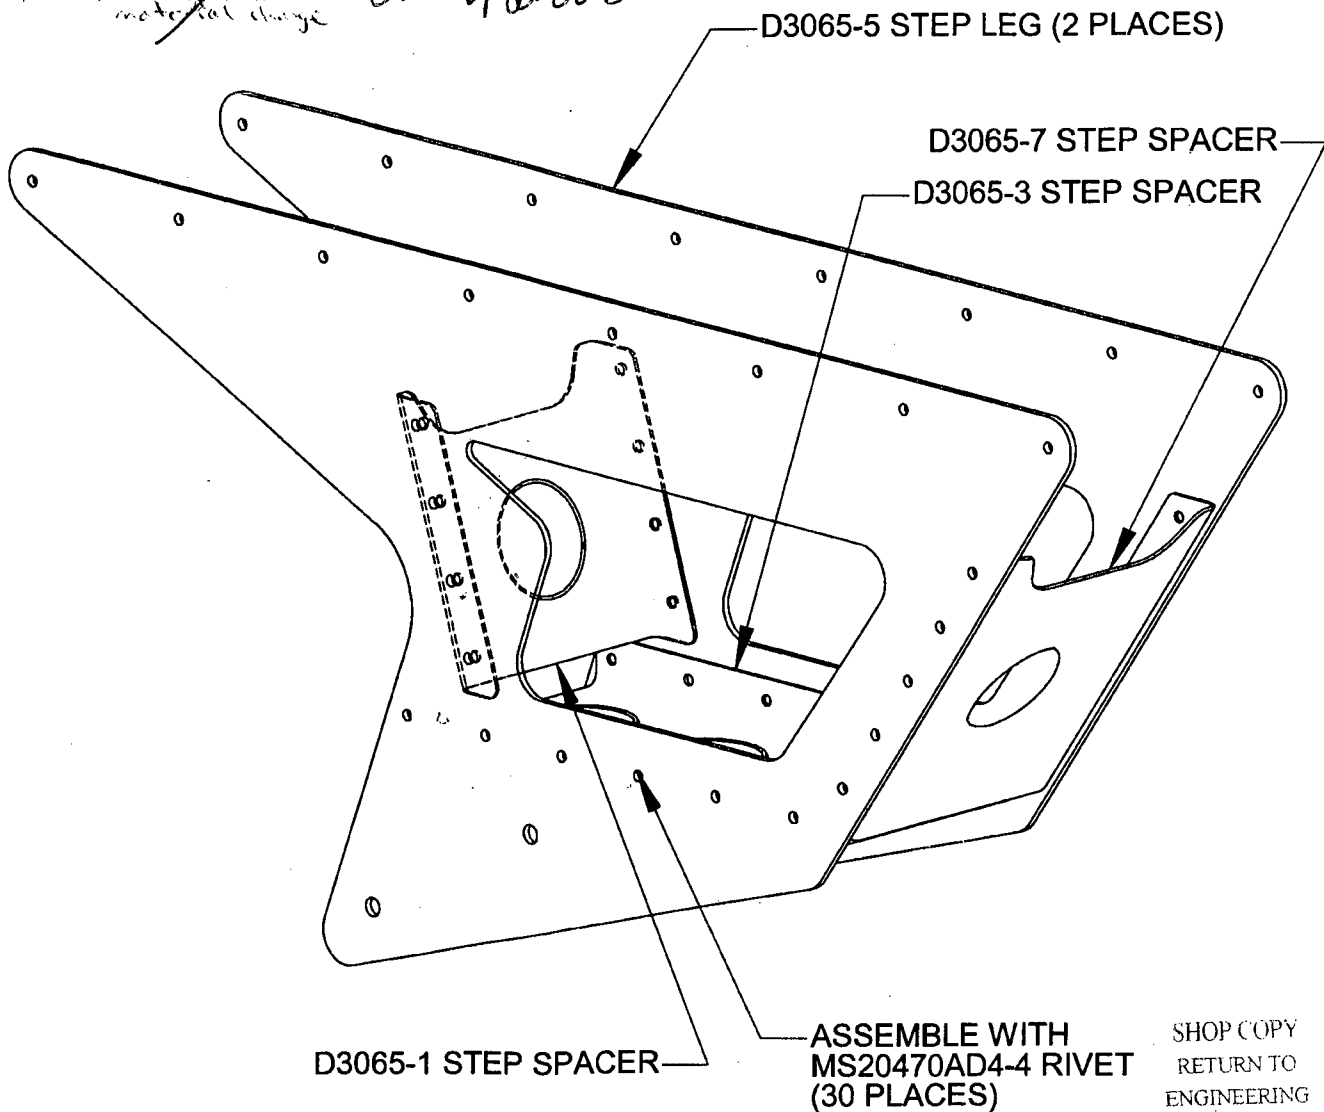

D3065-041 STEP LEG ASSEMBLY

SHOP COPY
RETURN TO
ENGINEERING
UNCONTROLLED COPY
SUBJECT TO AMENDMENT
WITHOUT NOTICE
WORK ORDER
NO. **27590 C**

COPYRIGHT © 2002 BY DART AEROSPACE LTD.


THIS DOCUMENT IS PRIVATE AND CONFIDENTIAL AND IS SUPPLIED ON THE EXPRESS CONDITION THAT IT IS NOT TO BE USED FOR ANY PURPOSE OR COPIED OR COMMUNICATED TO ANY OTHER PERSON WITHOUT WRITTEN PERMISSION FROM DART AEROSPACE LTD.

RELEASED
02.09.20

DART



DESIGN <i>CP</i>	DRAWN BY <i>CP</i>	DART AEROSPACE LTD HAWKESBURY, ONTARIO, CANADA	
CHECKED <i>A</i>	APPROVED <i>A</i>	DRAWING NO. D3065	REV. A SHEET 3 OF 5
DATE 02.09.11		TITLE STEP LEG ASSEMBLY	SCALE 1:1

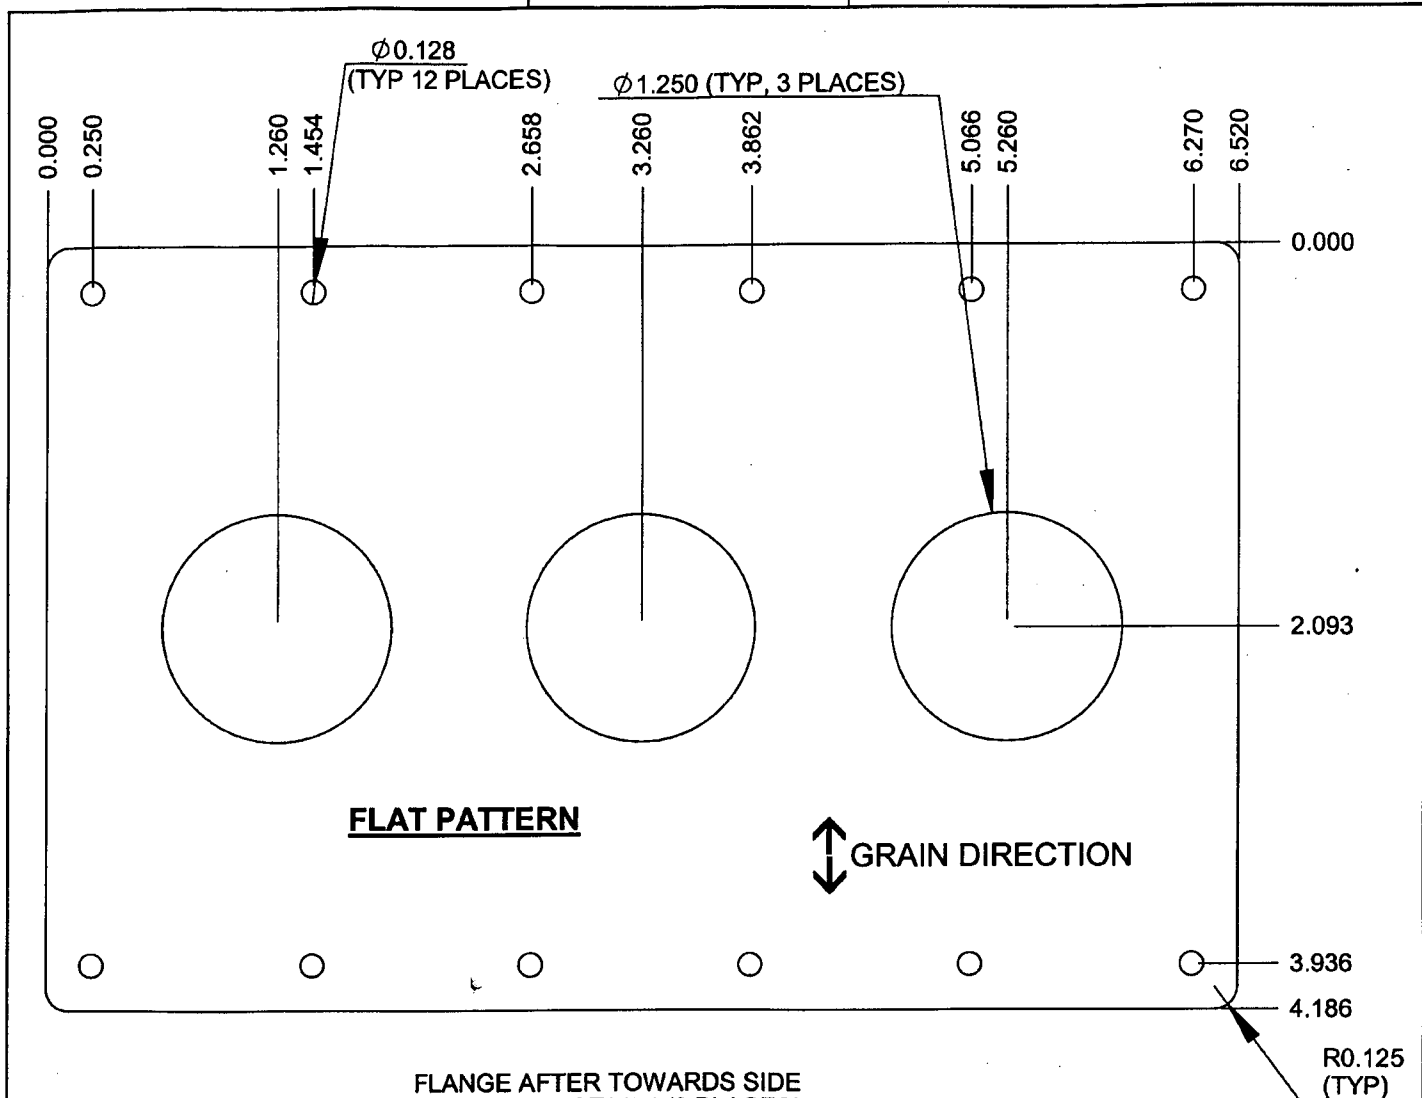


FLANGE AFTER TOWARDS SIDE
SHOWN USING DT8174 (3 PLACES)

UNDER REVIEW

06.06.02 CB

material change

OK
06.06.15

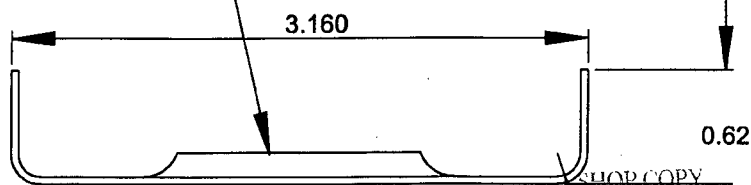

D3065-3 STEP SPACER

- 1) MATERIAL: 2024-T3 (QQ-A-250/4)
0.040 THICK (REF DART SPEC. M2024T3S.040)
- 2) FINISH: ACID ETCH & ALODINE PER DART QSI 005 4.1
- 3) PART IS SYMMETRIC ABOUT CENTERLINE
- 4) BREAK ALL SHARP EDGES 0.005 TO 0.010
- 5) TOLERANCES ARE PER DART QSI 018 UNLESS OTHERWISE NOTED

UNCONTROLLED COPY
SUBJECT TO AMENDMENT
WITHOUT NOTICE

WORK ORDER
NO. *27590C*


COPYRIGHT © 2002 BY DART AEROSPACE LTD.

THIS DOCUMENT IS PRIVATE AND CONFIDENTIAL AND IS SUPPLIED ON THE EXPRESS CONDITION THAT IT IS NOT TO BE USED FOR ANY PURPOSE OR COPIED OR COMMUNICATED TO ANY OTHER PERSON WITHOUT WRITTEN PERMISSION FROM DART AEROSPACE LTD.

2. A COPY ISSUED

DESIGN <i>CP</i>	DRAWN BY <i>CP</i>	DART AEROSPACE LTD HAWKESBURY, ONTARIO, CANADA	
CHECKED <i>[Signature]</i>	APPROVED <i>[Signature]</i>	DRAWING NO. D3065	REV. A SHEET 4 OF 5
DATE 02.09.11		TITLE STEP LEG ASSEMBLY	SCALE 1:3

RECORDED
02.09.20 #

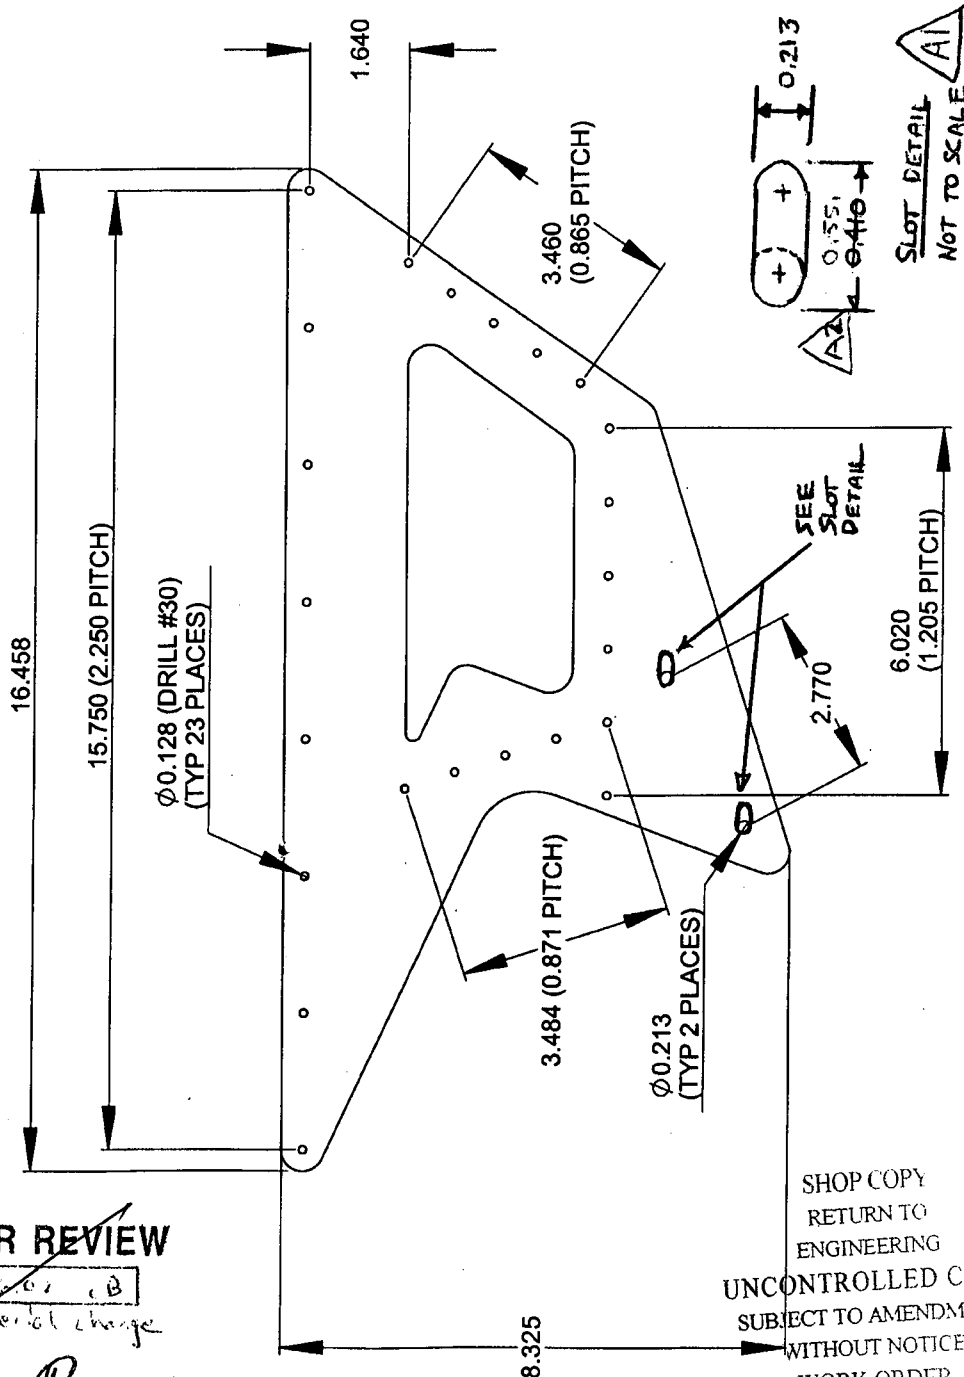

UNDER REVIEW

~~α. 66.07 (B)~~

material change

OK

Pos. 06.15

SHOP COPY
RETURN TO
ENGINEERING
UNCONTROLLED COPY
SUBJECT TO AMENDMENT
WITHOUT NOTICE
WORK ORDER
NO. 27590C

D3065-5 STEP LEG

- 1) MACHINE PER DWG FILE "D3065-5.SLDPRT"
2) MATERIAL: 5052-H32 (QQ-A-250/8) 0.080 THICK (REF DART SPEC. M5052H32S.080)
3) FINISH: ACID ETCH & ALODINE PER DART QSI 005 4.1
4) BREAK ALL SHARP EDGES 0.005 TO 0.010
5) TOLERANCES ARE PER DART QSI 018 UNLESS OTHERWISE NOTED


COPYRIGHT ©2002 BY DART AEROSPACE LTD.

THIS DOCUMENT IS PRIVATE AND CONFIDENTIAL AND IS SUPPLIED ON THE EXPRESS CONDITION THAT IT IS NOT TO BE USED FOR ANY PURPOSE OR COPIED OR COMMUNICATED TO ANY OTHER PERSON WITHOUT WRITTEN PERMISSION FROM DART AEROSPACE LTD.

DART

DESIGN <i>CP</i>	DRAWN BY <i>CP</i>	DART AEROSPACE LTD HAWKESBURY, ONTARIO, CANADA	
CHECKED <i>[Signature]</i>	APPROVED <i>[Signature]</i>	DRAWING NO. D3065	REV. A SHEET 5 OF 5
DATE 02.09.11		TITLE STEP LEG ASSEMBLY	SCALE 1:1

RELEASED
02.09.20

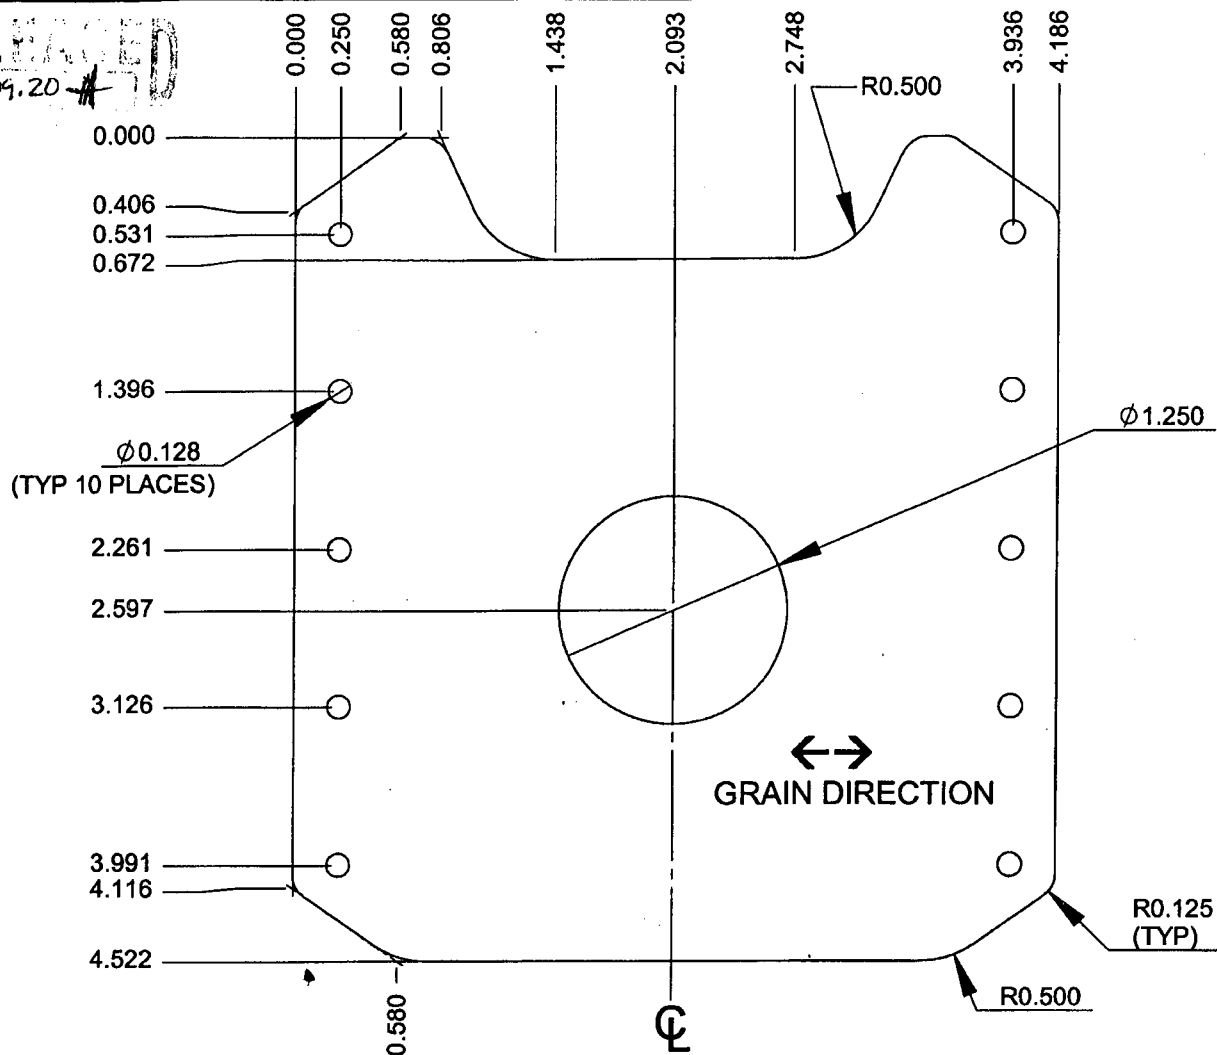


FLANGE AFTER BENDING TOWARDS
SIDE SHOWN USING DT8174 (2 PLACES)

UNDER REVIEW

06.06.05 (13)
material change

OK *CP* 06.06.05

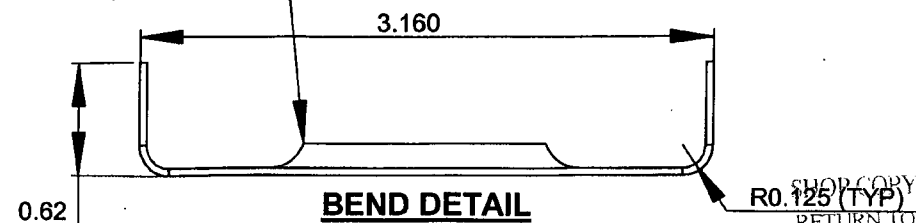

D3065-7 STEP SPACER

- 1) MATERIAL: 2024-T3 (QQ-A-250/4) 0.040 THICK (REF DART SPEC. M2024T3S.040)
- 2) FINISH: ACID ETCH & ALODINE PER DART QSI 005 4.1
- 3) PART IS SYMMETRIC ABOUT CENTERLINE
- 4) BREAK ALL SHARP EDGES 0.005 TO 0.010
- 5) TOLERANCES ARE PER DART QSI 018 UNLESS OTHERWISE NOTED

SHOP COPY
RETURN TO
ENGINEERING
FOR CONTROLLED COPY
SUBJECT TO AMENDMENT
WITHOUT NOTICE
WORK ORDER
NO. 27590 c

COPYRIGHT ©2002 BY DART AEROSPACE LTD.

THIS DOCUMENT IS PRIVATE AND CONFIDENTIAL AND IS SUPPLIED ON THE EXPRESS CONDITION THAT IT IS NOT TO BE USED FOR ANY PURPOSE OR COPIED OR COMMUNICATED TO ANY OTHER PERSON WITHOUT WRITTEN PERMISSION FROM DART AEROSPACE LTD.

<input checked="" type="checkbox"/>	First Article	<input checked="" type="checkbox"/>	Prototype
-------------------------------------	---------------	-------------------------------------	-----------

~~Scrub~~
Rec'd for Oct 9

06 07 06


Revised by	Approved
KJ/JLM	

FIRST ARTICLE INSPECTION CHECKLIST

☒ First Article ☒ Prototype

[illegible]

Measured by:	<i>MM: MM</i>
Date:	<i>08.08.29</i>

Audited by:	
Date:	16.09.05

Prototype Approval:	N/A
Date:	

Rev	Date	Change	Revised by	Approved
A		New Issue	KJ/JLM	